


Construction Details



- A. Splice loop detector to existing 2 conductor aluminum shielded cable.  
B. Abandon existing loop detector.  
C. Install handhole.  
D. Install 1 in. liquid tight, flexible, non-metallic conduit for detector wire sleeve.  
E. Install 6 ft. x 6 ft. loop detector (4 turns) encased in flexible tubing.  
F. Remove/grind existing pavement marking.  
G. Relocate existing ground mounted sign.  
H. Install 24 in. white permanent preformed pavement marking tape.  
J. Use existing handhole.  
K. Abandon existing conduit.  
L. Install 6 ft. x 30. ft. quadruple loop detector (3-6-3 turns) encased in flexible tubing.  
M. Use existing conduit.  
N. Install 2 in. PVC schedule 40 electrical conduit - trenched.  
O. Remove existing ground mounted sign.  
P. Install ground mounted sign.  
Q. Relocate existing signal heads and sign as shown (Note: install electrical cables on span wire).  
R. Relocate existing signal heads as shown.  
S. Pavement markings to be removed by others.  
T. Abandon existing handhole.  
U. Disconnect existing loop detector (Note: loop detectors shall be utilized for the ultimate signal).  
V. Install three 1 in. liquid tight flexible, non-metallic conduit for detector wire sleeves  
W. Install permanent preformed pavement marking arrow or letter as shown..  
X. Install 6 ft. x 6 ft. loop detector (4-turns) encased in flexible tubing and spliced to existing 2 conductor aluminum shielded cable  
Y. Install 6 ft. x 30 ft. quadruple loop detector (3-6-3 turns) encased in flexible tubing and splice to existing 2-conductor aluminum shielded cable.

F.H.W.A. REGION NO.	STATE	FED. AID PROJ. NO.	SHEET NO.	TOTAL SHEETS
3	MD	SEE TITLE SHEET		

EXISTING SIGNALS

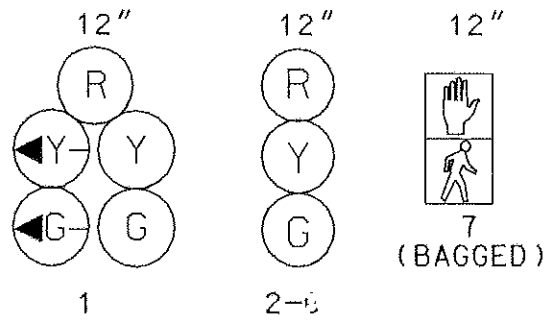


NEMA PHASING

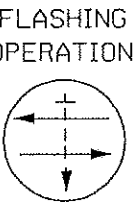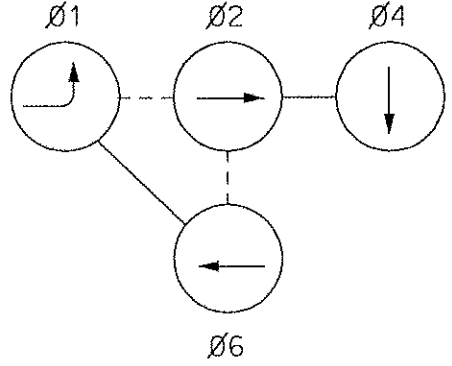


PHASING NOTES:  
1. PHASES ASSOCIATED BY A DASHED LINE  
WILL OPERATE CONCURRENTLY.  
2. PHASES ASSOCIATED BY A SOLID LINE  
WILL NOT OPERATE CONCURRENTLY.

EXISTING SIGNS

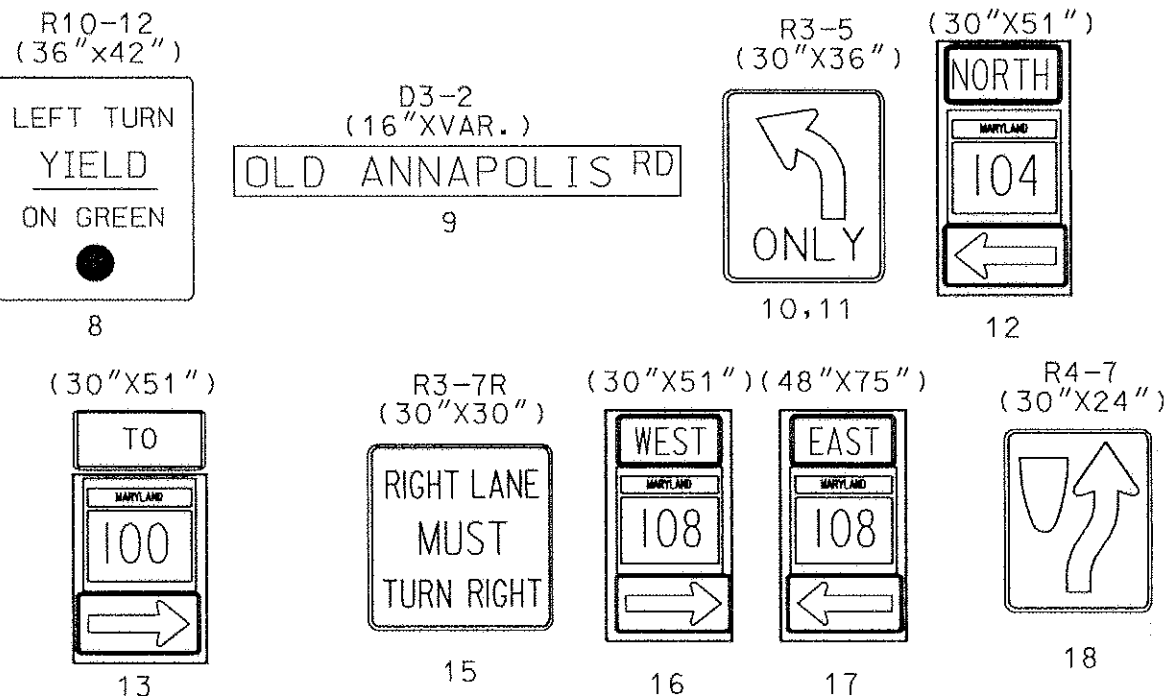


PROPOSED SIGN

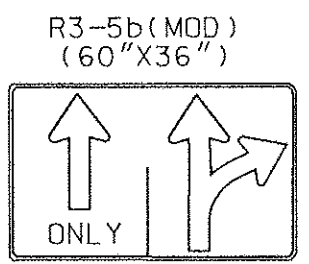

14  
(GROUND MOUNT)

MD 108 IS ASSUMED TO RUN IN A  
EAST/ WEST DIRECTION

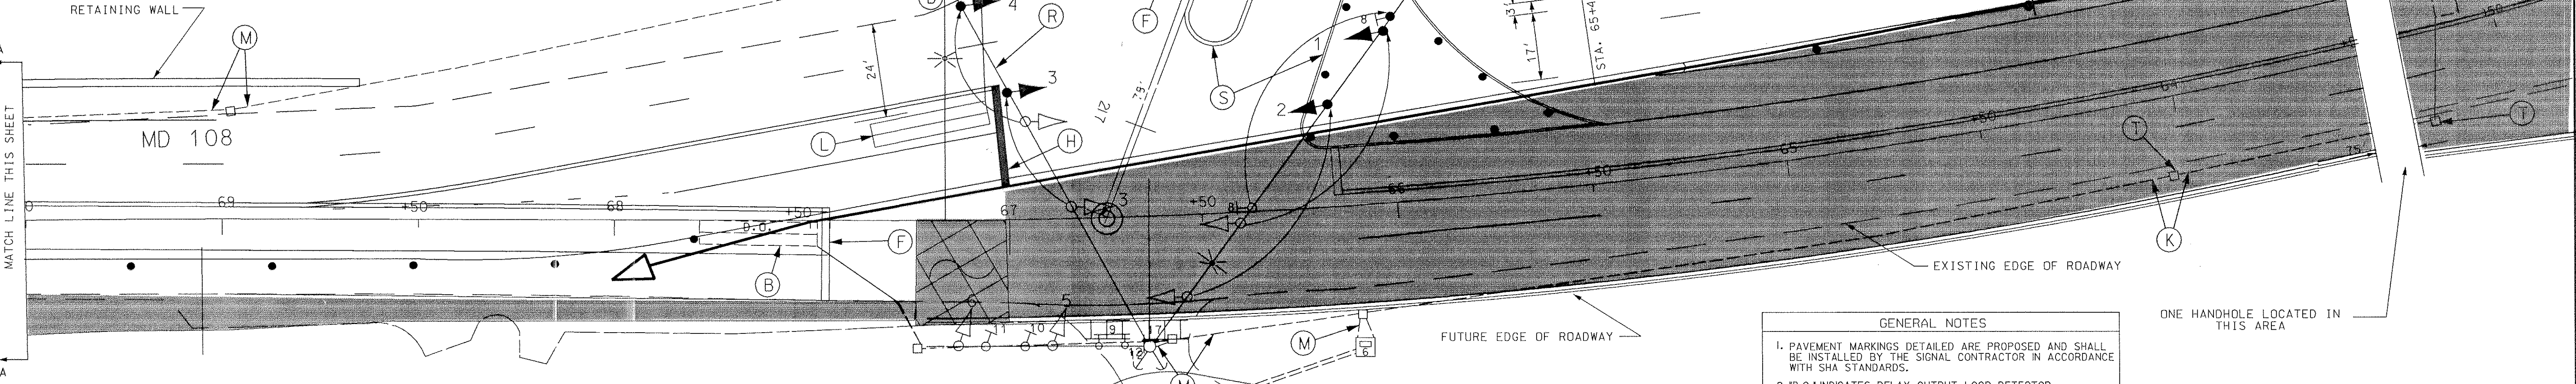

MOT LEGEND

- • • TEMPORARY CONCRETE BARRIER  
• • • CHANNELIZING DEVICES  
△ IMPACT ATTENUATOR  
■ BASE WIDENING  
▨ TEMPORARY PAVEMENT

UTILITY LEGEND

- T — T — TELEPHONE CABLES  
G — G — GAS MAIN  
W — W — WATER MAIN  
S — S — SEWER MAIN  
E — E — ELECTRIC CABLES  
A — A — AERIAL CABLES  
BC — BC — BURIED CABLE  
SD — SD — STORM DRAIN

GEOMETRIC LEGEND

- — — EXISTING GEOMETRICS  
— — — PROPOSED GEOMETRICS

GENERAL NOTES

- PAVEMENT MARKINGS DETAILED ARE PROPOSED AND SHALL BE INSTALLED BY THE SIGNAL CONTRACTOR IN ACCORDANCE WITH SHA STANDARDS.
- "D.O." INDICATES DELAY OUTPUT LOOP DETECTOR.
- THE LOOP DETECTORS SHALL BE INSTALLED PRIOR TO THE INSTALLATION OF THE PAVEMENT MARKINGS.
- CONTRACTOR MUST VERIFY THE LOCATION OF ALL PROPOSED GEOMETRICS PRIOR TO INSTALLING SIGNAL EQUIPMENT.
- ALL PROPOSED TRAFFIC SIGNAL EQUIPMENT SHALL BE INSTALLED TO FINAL GRADE.
- REFER TO MAINTENANCE OF TRAFFIC PLANS FOR ADDITIONAL DETAILS OF MAINTENANCE OF TRAFFIC.
- CONTRACTOR SHOULD LEAVE 50 FT. OF SLACK FOR ELECTRICAL WIRING OF SIGNAL HEADS.
- REFER TO M.O.T. PLANS FOR ADDITIONAL ROADWAY PAVEMENT MARKINGS AND SIGNING.

SIG-14

TEMPORARY SIGNAL #7  
PHASE III

MARYLAND DOT - STATE HIGHWAY ADMINISTRATION  
Office of Traffic & Safety  
TRAFFIC ENGINEERING DESIGN DIVISION

ORIGINAL DRAWN BY R CICCHINI / J ALLEN  
DES. BY S CHERNACK / D PETERS  
CHK. BY Bruce Thompson 11-7-96

MD 108 AT TEMP MD 104

LOG MILE NO. COUNTY: HOWARD

DATE: 10/96 F.A.P. NO. SEE TITLE SHEET  
SCALE: 1"=20' S.H.A. NO. HO-661-502-770

TS/FILE NO. 3611 SHEET NO. 425 OF

REVISIONS

APPROVALS

1. 11/13/96  
ASST. DIV. CHIEF, SIGNAL DESIGN SECTION  
2. 11/23/96  
ASST. DISTRICT ENGINEER, TRAFFIC  
3. 11/23/96  
CHIEF, TRAFFIC ENGINEERING DESIGN DIVISION  
4. 11/1/96  
DEPUTY CHIEF ENGINEER, OFFICE OF TRAFFIC

REDLINE NO. 9  
DELETE THIS SHEET

JDCL  
CONSULTING ENGINEERS  
COLUMBIA, MARYLAND

